

UNIT DEEDSEA PINES CONDOMINIUM 1

COMPTON ALLYN AND ELIZABETH D. ALLYN, husband and wife as tenants by the entirety, both of 3525 Holly Avenue, Cincinnati, Ohio ("Grantor")

for consideration of ONE HUNDRED TEN THOUSAND AND 00/100 (\$110,000.00) DOLLARS paid

grant to VIRGINIA A. ANANIA of 9R Lyman Wheelock Road, South Easton, Massachusetts 02375 ("Grantee")

with QUITCLAIM COVENANTS, the unit ("Unit") known as Unit A in Building 4 ("Building") of Sea Pines Condominium 1, Sea Pines Drive, Brewster, Barnstable County, Massachusetts, a condominium established by Corcoran, Mullins, Jennison, Inc., a Massachusetts corporation having its principal place of business in East Milton, Massachusetts, pursuant to Massachusetts General Laws, Chapter 183A by Master Deed dated October 9, 1973 and recorded with Barnstable Registry of Deeds at Book 1948, Page 53 ("Master Deed") which Unit is shown on the floor plans of the Building filed simultaneously with said Master Deed in Barnstable Deeds and on the copy of the portion of said plans attached hereto and made a part hereof, to which is affixed the verified statement of a registered architect in the form required by Section 9 of said Chapter 183A.

Said Unit is conveyed together with:

1. An undivided 3.11 percent interest in the common areas and facilities of the Property described in said Master Deed ("Common Elements") attributable to the Unit.
2. An exclusive right to use garaged parking space Number 30 as shown on the plans filed with the Master Deed, and the right to use one open parking space within the open parking area shown on the plans filed with the Master deed.
3. An exclusive right to use (i) the patio or balcony and (ii) any immediately adjacent attic or storage areas to which there is direct access from the Unit.
4. An easement for the continuance of all encroachments by the unit on any adjoining units or Common Elements existing as a result of construction of the building in which the Unit is located, or which may come into existence hereafter as a result of settling or shifting of the building, or as a result of repair or restoration of the building or of the Unit, after damage or destruction by fire or other casualty, or after taking in condemnation or eminent domain proceedings, or by reason of an alteration or repair to the Common Elements made by or with the consent of the Board of Managers.
5. An easement in common with the owner of other units

to use any pipes, wires, ducts, flues, cable, conduits, public utility lines and other Common Elements located in any of the other units or elsewhere on the Property, and serving the Unit.

6. The following rights and easements in common with other Unit Owners, all as described in the Master Deed: common driveway easement; common utility easement; rights to use the recreational facilities and easternmost 700' of beach, as more specifically described and limited in the By-Laws recorded with the Master Deed.

Said Unit is conveyed subject to:

(1) Grant of Utility Easement to Corcoran, Mullins, Jennison, Inc., dated August 16, 1973, and recorded in the Barnstable County Registry of Deeds in Book 1922, Page 1, which is incorporated herein by reference.

(2) Easements in favor of adjoining units and in favor of the Common Elements for the continuance of all encroachments of such adjoining units or Common Elements on the Unit, now existing as a result of construction of the Building, or which may come into existence hereafter as a result of settling or shifting of the Building or of any adjoining unit or of the Common Elements after damage or destruction by fire or other casualty or after a taking in condemnation or eminent domain proceedings, or by reason of an alteration or repair to the Common Elements made by or with the consent of the Board of Managers.

(3) An easement in favor of the other units to use the pipes, wires, ducts, flues, conduits, cables, public utility lines and other Common Elements located in the Unit or elsewhere on the Property and serving such other units.

(4) Exclusive rights in favor of the owner of any Unit to use designated Parking space.

(5) Exclusive rights in favor of the owner of any Unit having sole access to a patio, balcony, attic or storage space directly from the interior of such Unit to use such space.

(6) The provisions of the Master Deed, By-Laws and floor plans of the Condominium recorded simultaneously with and as part of the Master Deed, as the same may be amended from time to time by instrument recorded in Barnstable Deeds, which provisions, together with any amendments thereto, shall constitute covenants running with the land and shall bind any person having at any time any interest or estate in the Unit, his family, servants, lessees and visitors, as though such provisions were recited and stipulated at length therein.

The Unit is intended only for residential purposes. No use may be made of the unit except as a residence for the Owner thereof or of his permitted lessees and the members of their immediate families.

For title, reference is made to a deed to us dated December 27, 1973 and recorded in Barnstable County Registry of Deeds Book 1984, Page 113.

Executed as a sealed instrument this 9<sup>th</sup> day of August 1983.

Compton Allyn  
COMPTON ALLYN

Elizabeth D. Allyn  
ELIZABETH D. ALLYN

COMMONWEALTH OF MASSACHUSETTS

Barnstable, ss.

August 9, 1983

Then personally appeared the above named COMPTON ALLYN AND ELIZABETH D. ALLYN and acknowledged the foregoing instrument to be their free act and deed, before me


Susan M. Jackson  
Notary Public

My commission expires: 1/02/86




CANCELLED

BARNSTABLE

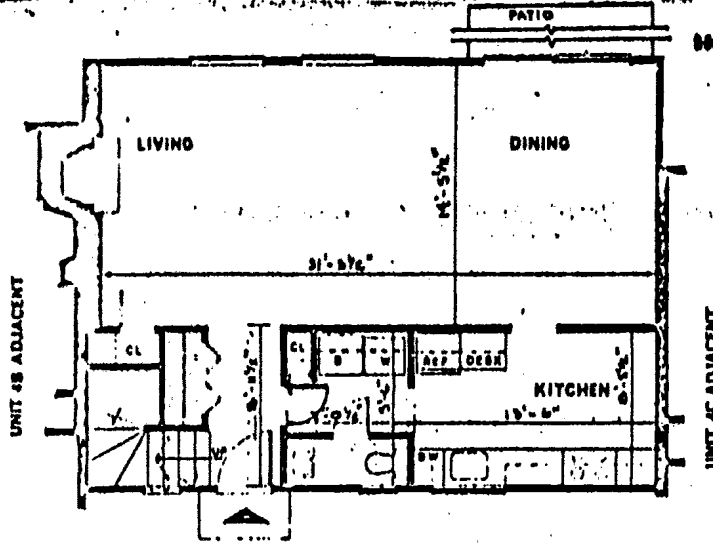

LOWER LEVEL

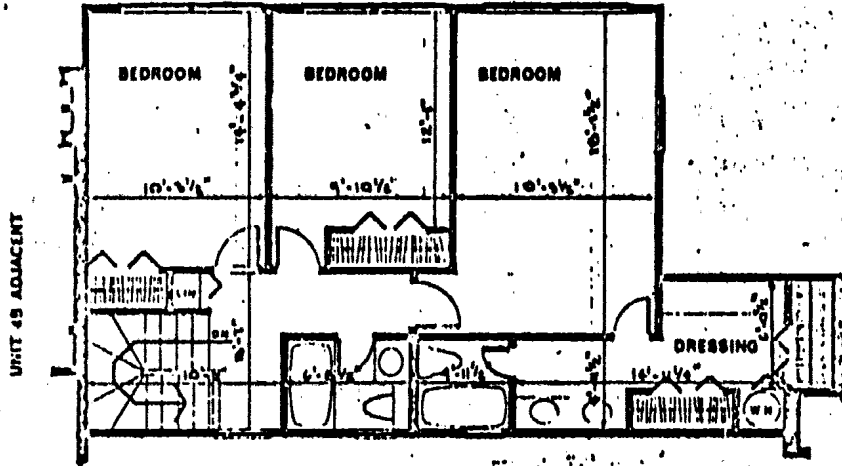

UPPER LEVEL

(1975 04-11)

# UNIT 4A

### CERTIFICATE FOR MASTER PLANS

I, Francis N. Bellon, Registered Architect, hereby certify that the plans enclosed hereto show building number and unit designation, unit number of immediately adjoining units, or that there is none, fully and accurately depict the layout of each unit, approximate dimensions and area, and show the entrance and immediately common areas in which each unit is situated as built at Sea Pines Condominium I off Route 66, Brewster, Massachusetts, the location of each building number and unit number within a building being shown on a plan entitled "Sea Pines Condominiums, Phase I, Brewster, Massachusetts for Regional Development Co., Scale 1" = 40'-0", dated September 1973. Separable Survey Consultants, Inc., West Yarmouth, Massachusetts", filed concurrently with these plans.

#### Note:

- All square foot area designations shown on plans do not include patios, balconies, stairs, or exterior fireplace chimneys.
- All dimensions shown on plans are to inside faces of wall construction and from top of sub-floor to top of ceiling construction.

Subscribed and sworn to under the penalties of perjury:



# SEA PINES CONDOMINIUM 1

RECORDED DEC 20 1973

RECORDED AUG 9 1983